






ELEVATION TO ALFRETON ROAD

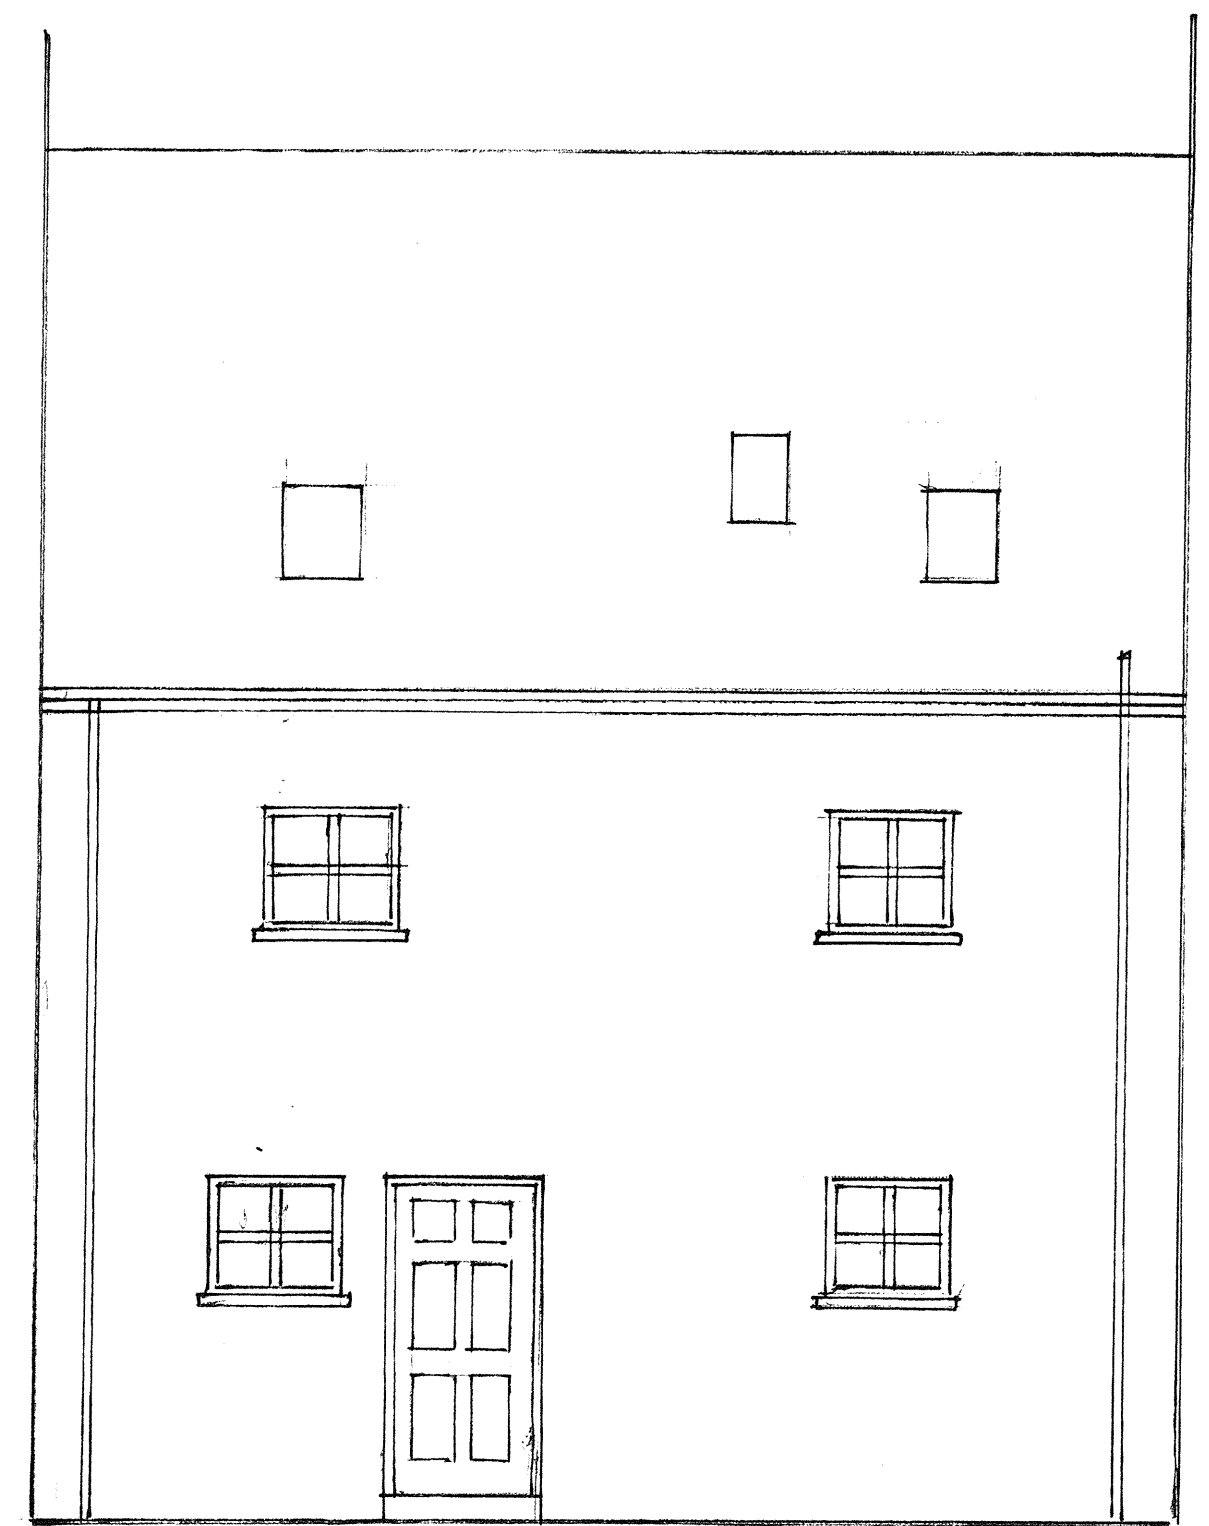


REAR ELEVATION

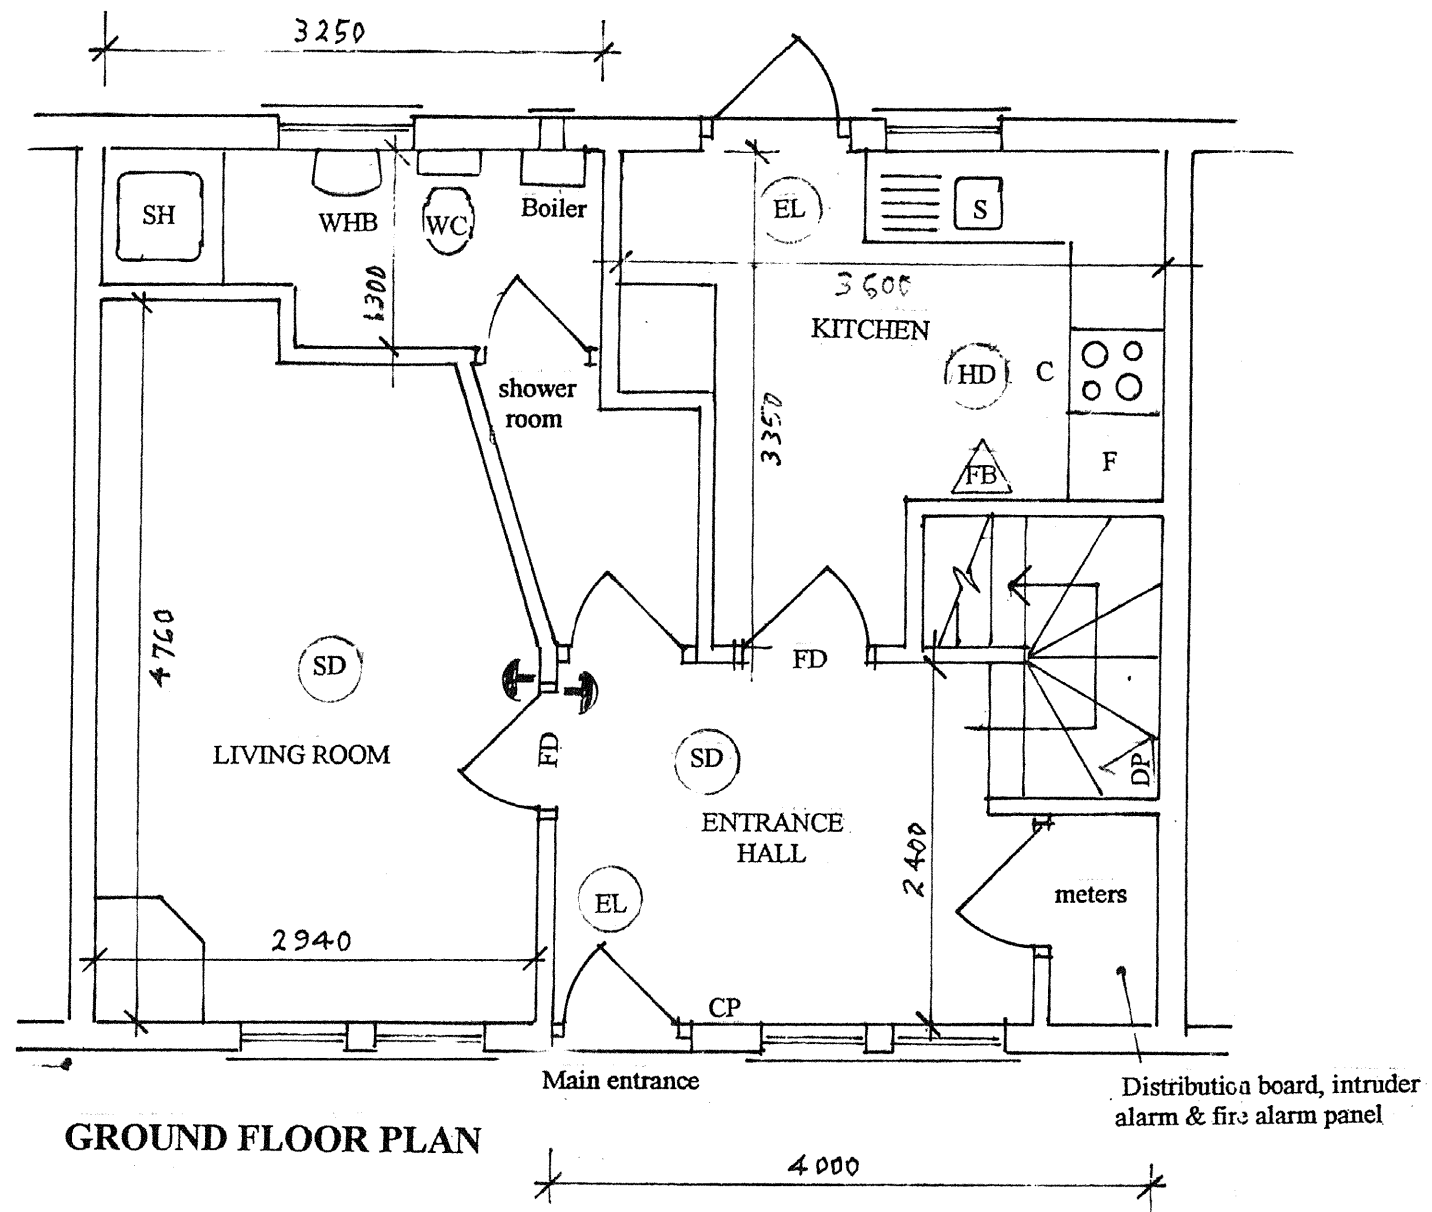

GROUND FLOOR PLAN

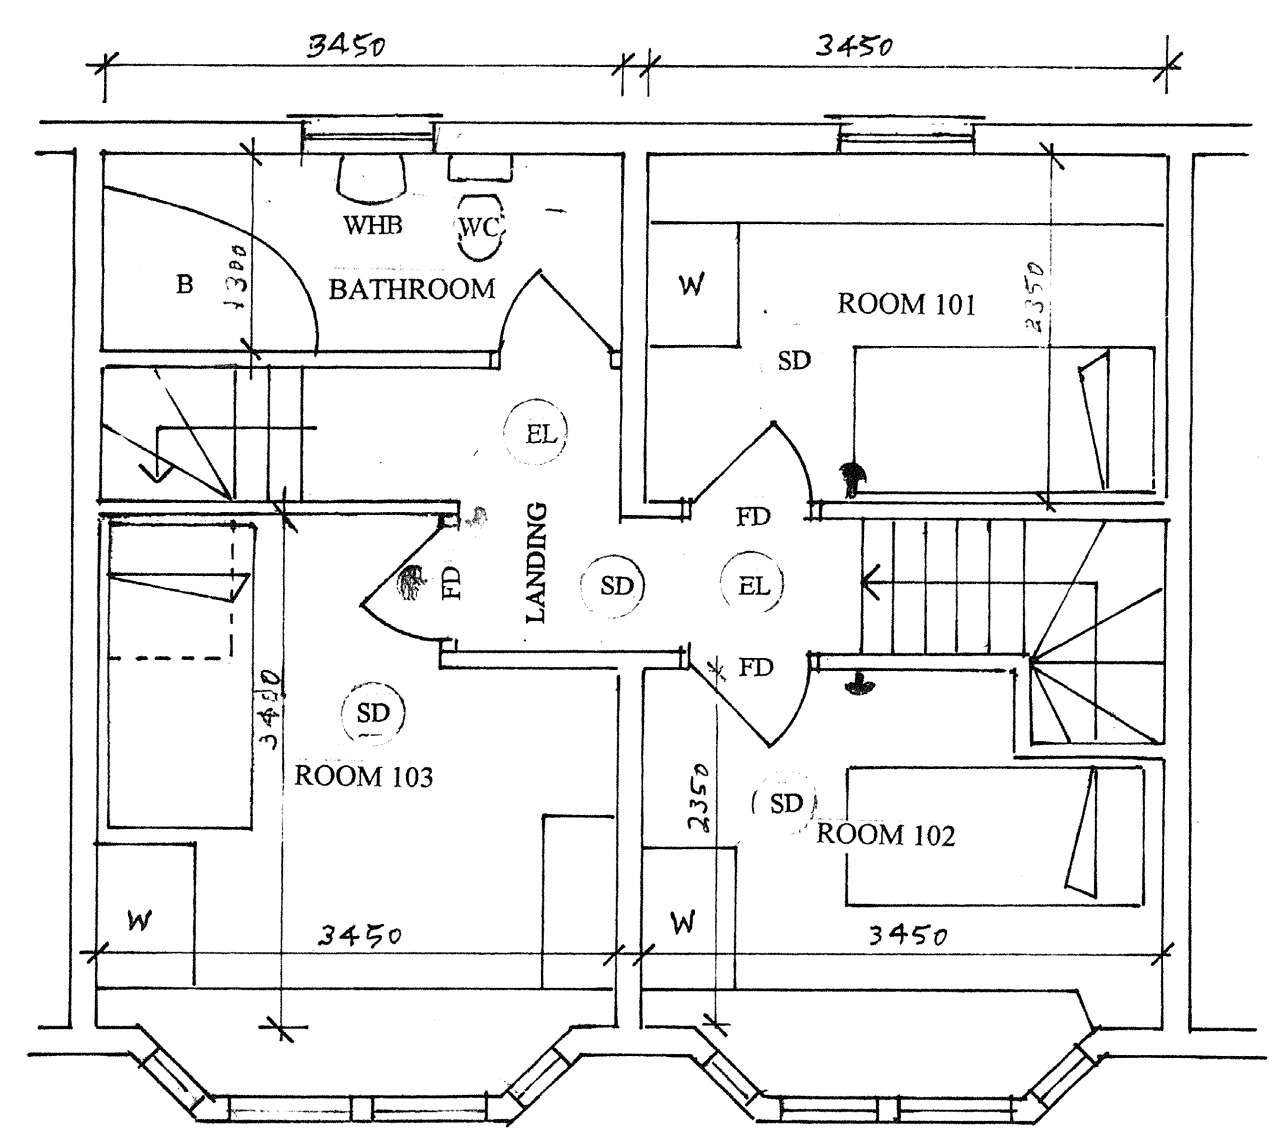

FIRST FLOOR PLAN

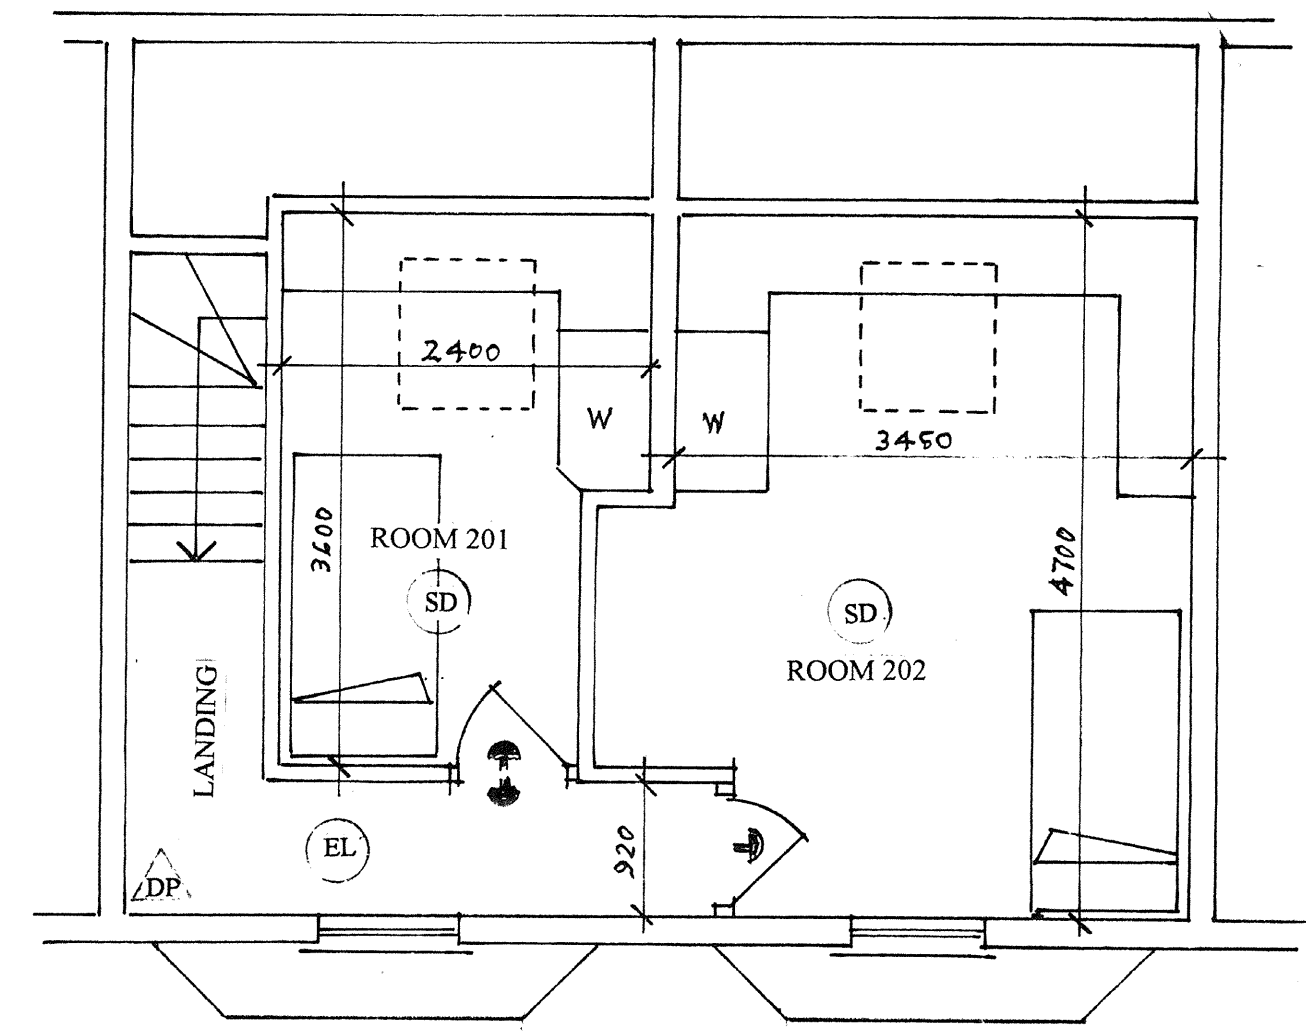

SECOND FLOOR PLAN

- Key of symbols**
- FD Fire door
 - EW Escape window
 - EL Emergency lighting
 - CP Manual call point
 - FAP Fire alarm control panel
 - SD Smoke detector linked to whole house system
 - HD Heat detector linked to whole house system
 - AS Alarm sounder linked to whole house system
 - SA Combined smoke detector/alarm, maybe linked or stand-alone
 - HA Combined heat detector/alarm, maybe linked or stand-alone
 - FB Fire blanket
 - WE Water extinguisher
 - FE Foam extinguisher
 - DP Dry powder extinguisher
 - SH Shower
 - B Bath
 - WC Toilet
 - WHB Wash-hand basin
 - C Cooker
 - S Sink
 - F Fridge

**MOLYNEUX SMITH
CHARTERED
ARCHITECTS**

54 GERTRUDE ROAD · WEST BRIDGFORD
NOTTINGHAM NG2 5DB
Tel: 0115 9822821 & 07973 181446

title:
AS-BUILT ARRANGEMENT

43-45 ALFRETON ROAD · NOTTINGHAM NG7 3JE
CLIENT: Mr. NANDHA

rev.	date	REVISIONS	scale	date
			1:50	08:06:09
			drawn by crms	checked by
			drawing no.	
			2153/AA(2) 01	